






This document and all information and data disclosed herein or herewith are the confidential and proprietary property of **MARITIME HYDRAULICS** and are not to be used, reproduced or disclosed in whole or in part by or to anyone without the written permission of **MARITIME HYDRAULICS**.

THIS IS A COMPUTER AIDED DRAWING AND MUST NOT BE ALTERED MANUALLY

Tolerances except as noted: NS-ISO 2768-1 (COARSE) DIN 8570-1 (CLASS B)

Welding except as noted: NS-EN 287-1 NS-EN 288

Rev.	Description of revision	Chk.	Appr.	Date / Sign.
01	ISSUED FOR PROJECT ACCEPTANCE	RAJ	RAJ	29-JAN-02/ROL
02	DRAWING UPDATED	RAJ	RAJ	21-MAY-02/JOAa
Z	AS BUILT	PHM	PHM	12-FEB-03/EFU

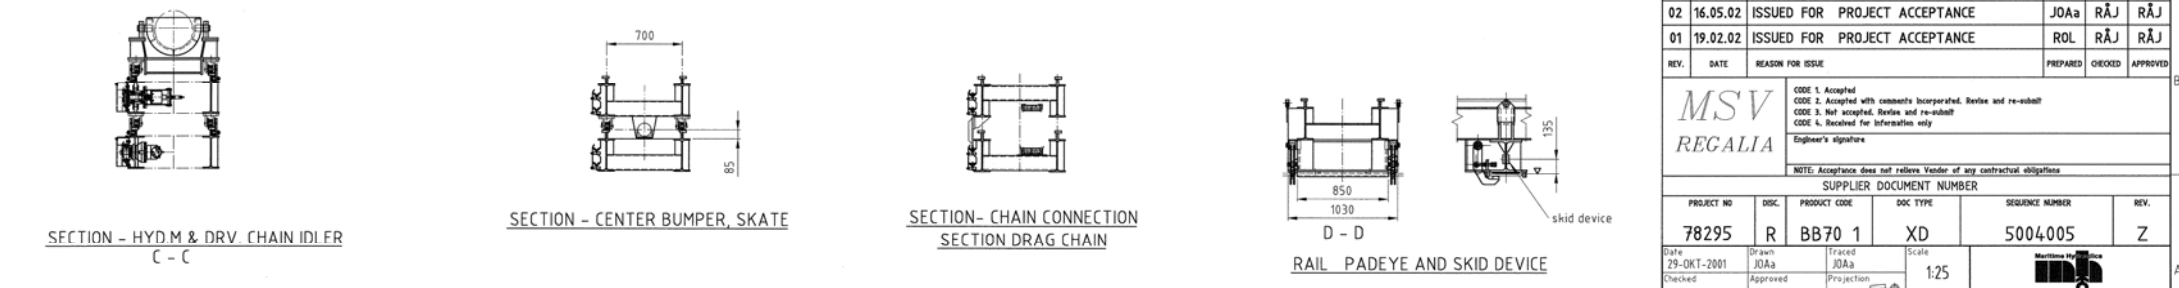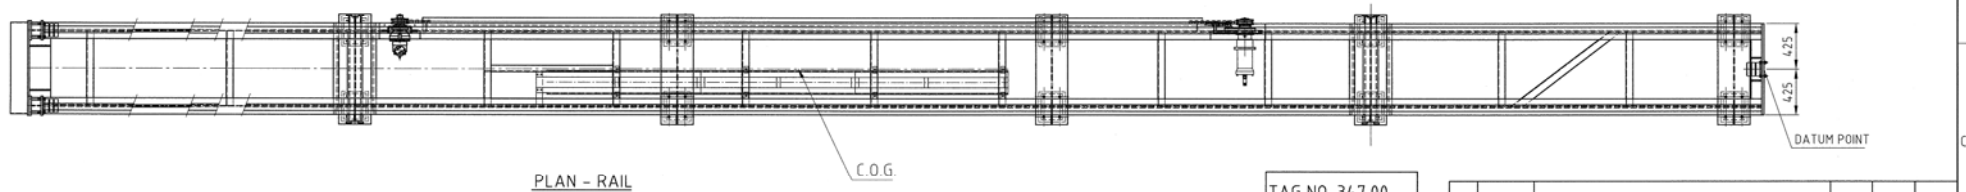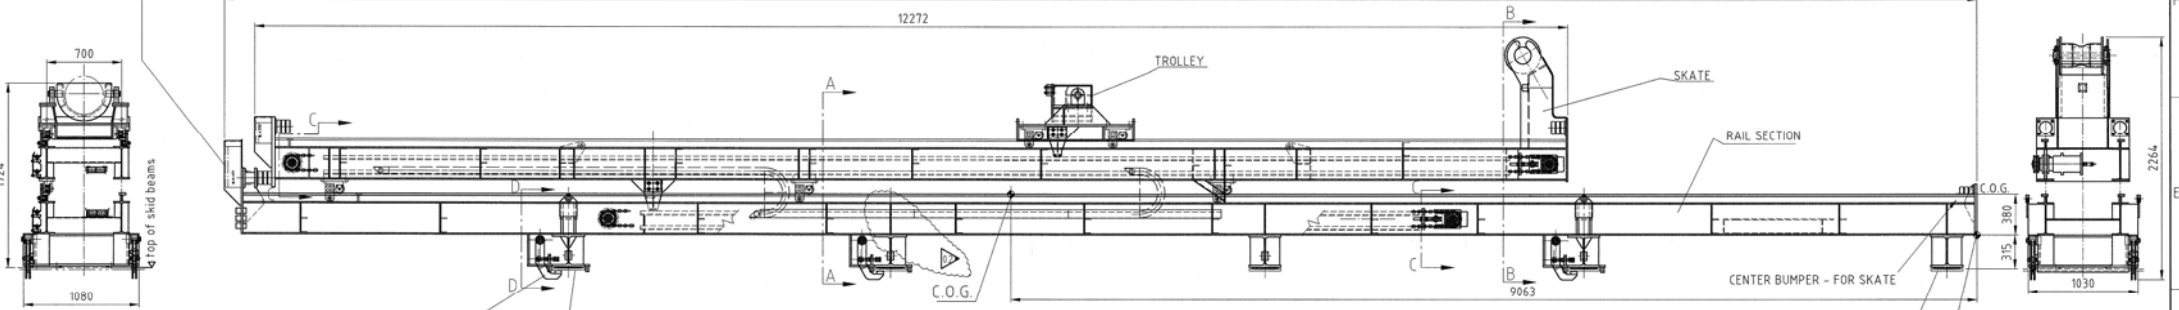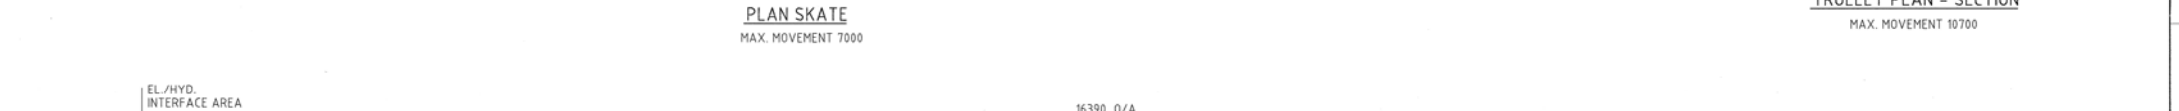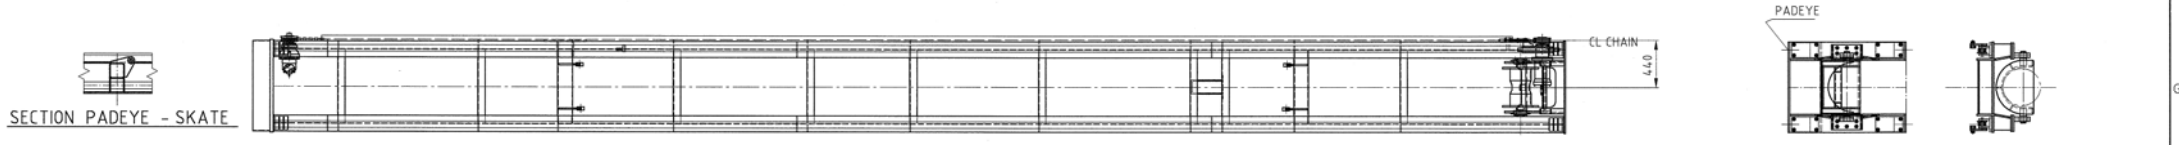

TAG NO. 347.00

TOTAL WEIGHT APPROX. 6700 kg

REV.	DATE	REASON FOR ISSUE	PREPARED	CHECKED	APPROVED
Z	12.02.03	AS BUILT			EFU
02	16.05.02	ISSUED FOR PROJECT ACCEPTANCE	JOAa	RAJ	RAJ
01	19.02.02	ISSUED FOR PROJECT ACCEPTANCE	ROL	RAJ	RAJ

MSV REGALIA

NOTE: Acceptance does not relieve Vendor of any contractual obligations

PROJECT NO	DISC	PRODUCT CODE	DOC TYPE	SEQUENCE NUMBER	REV.
78295	R	BB70 1	XD	5004005	Z

Date: 29-OCT-2001
 Drawn: JOAa
 Checked: Approved
 Traced: JOAa
 Projection: 1st Angle
 Scale: 1:25

MSV REGALIA HORIZONTAL RISER HANDLING MACHINE GENERAL ARRANGEMENT 3 OF 3

Replaces: A1
 Replaced by: MH 5004005